



DO NOT SCALE FROM THIS DRAWING
 © Crown copyright and database rights
 2019 Ordnance Survey 100049049

Survey Features Legend

ab	airbrick	ib	illuminated bollard
catv	cable tv cover	thl	threshold level
bo	bollard	il	invert level
cl	cover level	th	trial hole
bt	telecom cover	lp	lamp post
d.c.	drainage channel	utl	unable to lift
rs	road sign	ffl	finished floor level
dp	downpipe	vp	vent pipe
re	rodding eye	mh	manhole
er	earth rod	wo	washout
st	stop tap	mhc	combined manhole
ep	electric pole	wm	water meter
sl	silt level	mhs	storm manhole
fh	fire hydrant	wl	water level
tp	telegraph pole	mhf	foul manhole
gly	gully	ic	inspection chamber
tl	traffic light		

Utility Services Legend

Detected (D), As-Built (AB), Record Drawing (RD)
 Statutory Authority Records (SA)

o/h	Overhead Service
u/g	Underground Service
E	Electric
T	Telecom
W	Water
G	Gas
?	Unknown

INFORMATION ON UNDERGROUND SERVICES IS BELIEVED TO BE CORRECT BUT NO GUARANTEE IS GIVEN OR IMPLIED

Building Survey Notes

- Floor plans produced with MBS survey software, using both laser and tape measurements.
- All dimensions shown in millimetres unless otherwise stated.
- Accuracy is as specified in RICS guidance notes at 1:100 survey scale or better.

1		
REV.	AMENDMENT	ORG DATE



www.shropshire.gov.uk 0345 678 9000




**CASTLE HILL
 CAR PARK
 WHITCHURCH**
 PROPERTY NO: 0000

RECORD DRAWING

**TOPOGRAPHICAL SURVEY
 BASED ON OS DATA**

DWG. STATUS	-				
SCALE	1:200			@A3	
DRAWN BY	A.MORRIS				
DATE	09.08.2019				
UPDATED	-	REV.	-		
AREA	PROP.	PHASE	AEMFS	SHEET	
LS	011	05	S	011	

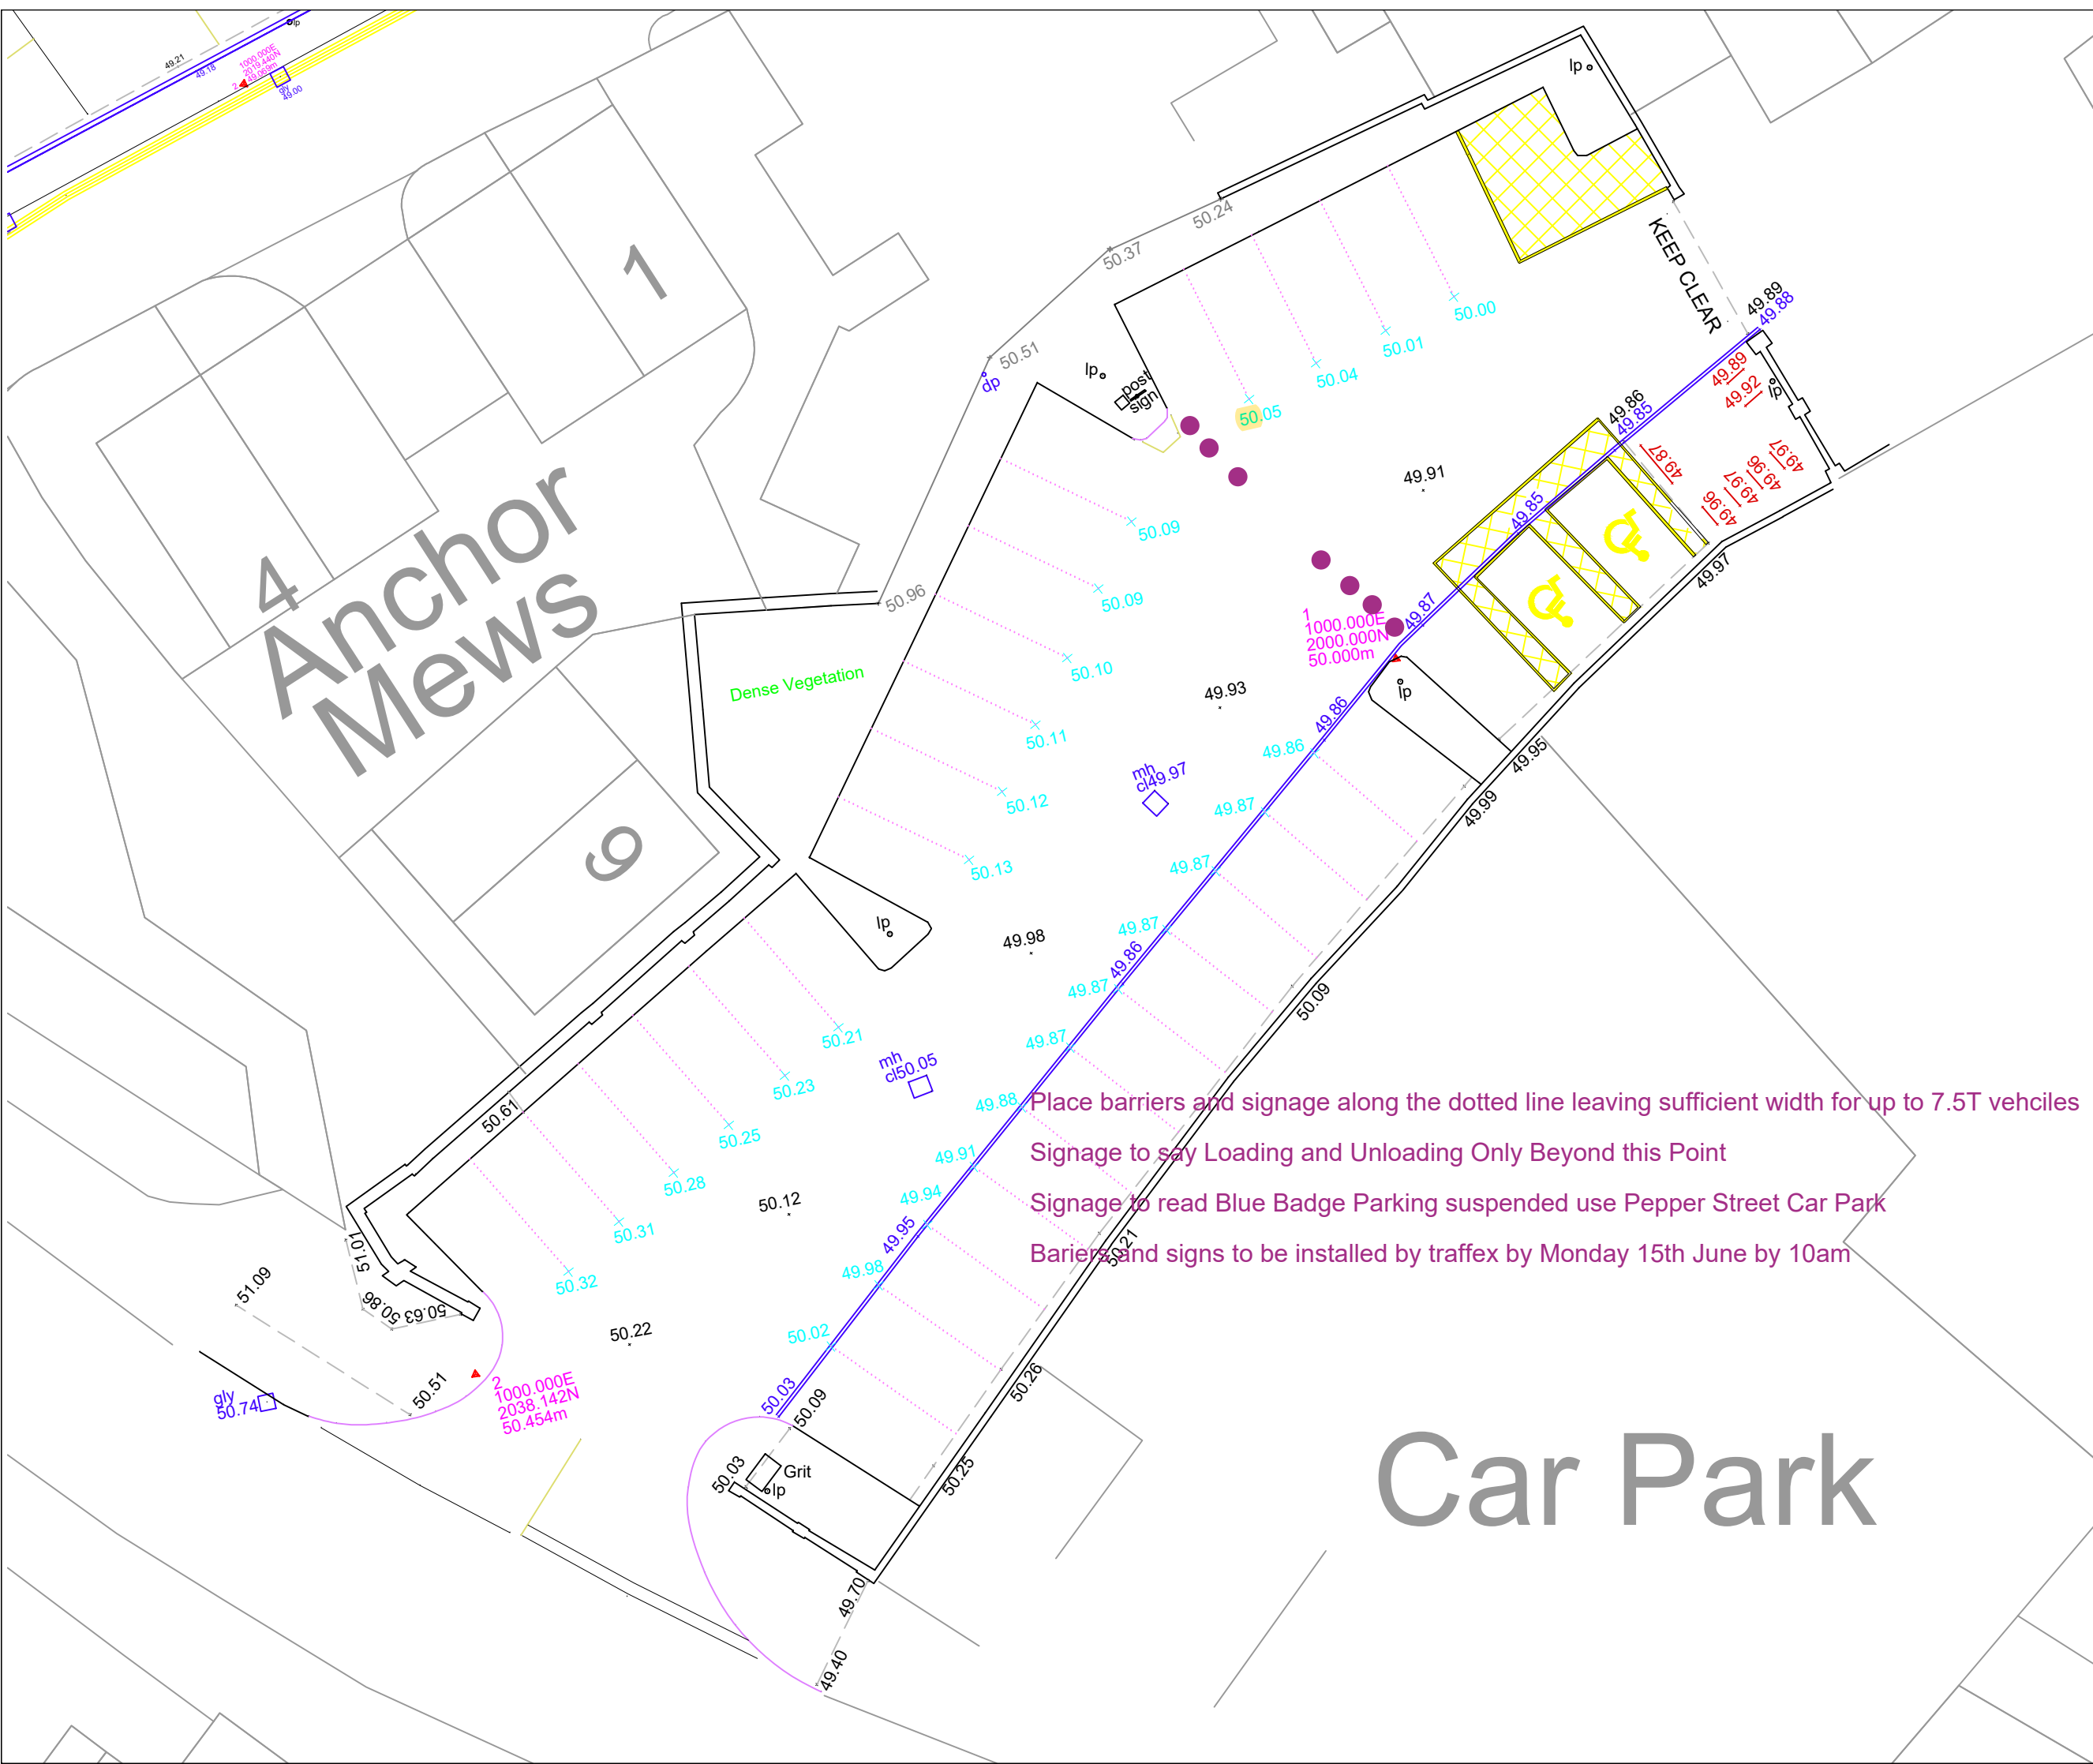

Place barriers and signage along the dotted line leaving sufficient width for up to 7.5T vehicles
 Signage to say Loading and Unloading Only Beyond this Point
 Signage to read Blue Badge Parking suspended use Pepper Street Car Park
 Barriers and signs to be installed by traffex by Monday 15th June by 10am

Car Park